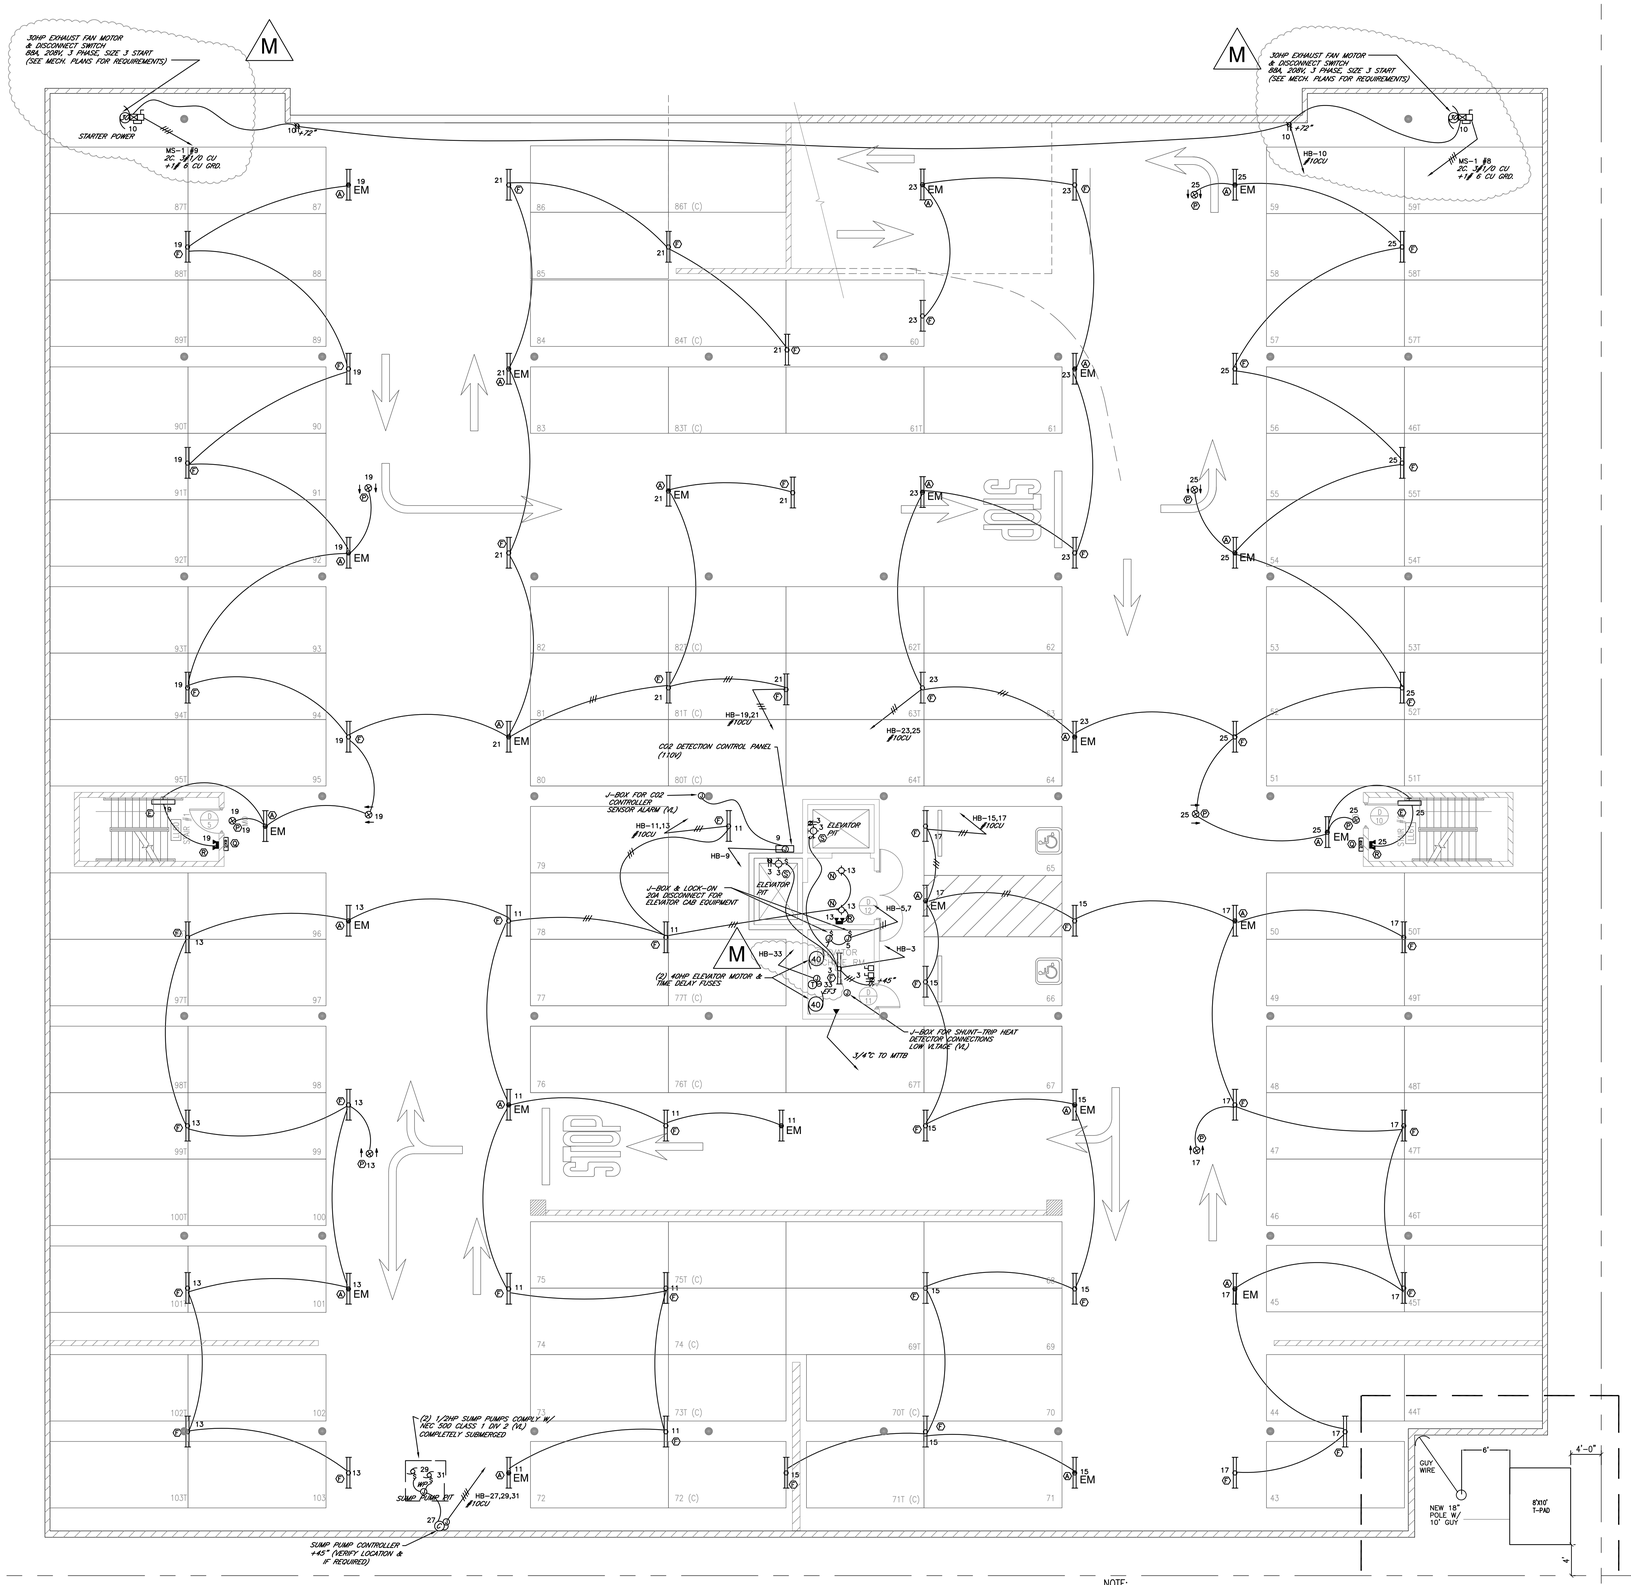

NOTE:
THERE SHALL BE NO PARKING STRUCTURE BELOW THE D.W.P. POWER SYSTEM SUPPLY (POWER POLE, POLE ANCHOR, TRANSFORMER PAD).

SATICOY STREET

LOWER BASEMENT PLAN

SCALE: 1/8"=1'-0"

NORTH

	DATE:
OWNER REVISIONS	-
4th BACKGROUNDS REVISED	8-1-05
DWP REPORT RECEIVED	8-26-05
DWP REVISION	5-1-06

CLIENT:
SATICOY INVESTMENT PROPERTIES

JOHN R. HANZLIK & ASSOC. INC.
CONSULTING ELECTRICAL ENGINEERING
7100 HAWKINHURST AVE. SUITE 301
VAN NUYS, CA. 91405-3904
T:818-901-1776 F:818-901-1962
Email: hanzlik@socal.net

FINAL PLAN CHECK / FOR CONSTRUCTION 5-4-06

91 UNIT
APARTMENT PROJECT

20237 W. SATICOY STREET
WINNETKA, CALIFORNIA
LOWER BASEMENT PLAN

E-3
OF 14 SHEETS

DATE 1-24-05
JOB # 5802

Joan Herman, John Hanzlik Assoc 4/7/2006 1:16 PM 1E3 LDW GAR.dwg